



STRUCTURAL MATERIAL: 16GA, 304SS, #3 BRUSHED FINISH


REV. NO.	DATE	DESCRIPTION / INITIALS
A	8/29/06	ADDED CLASS1, DIV1 ELECTRICAL COMPONENTS - BS
B	01/19/07	AS BUILTS - TB

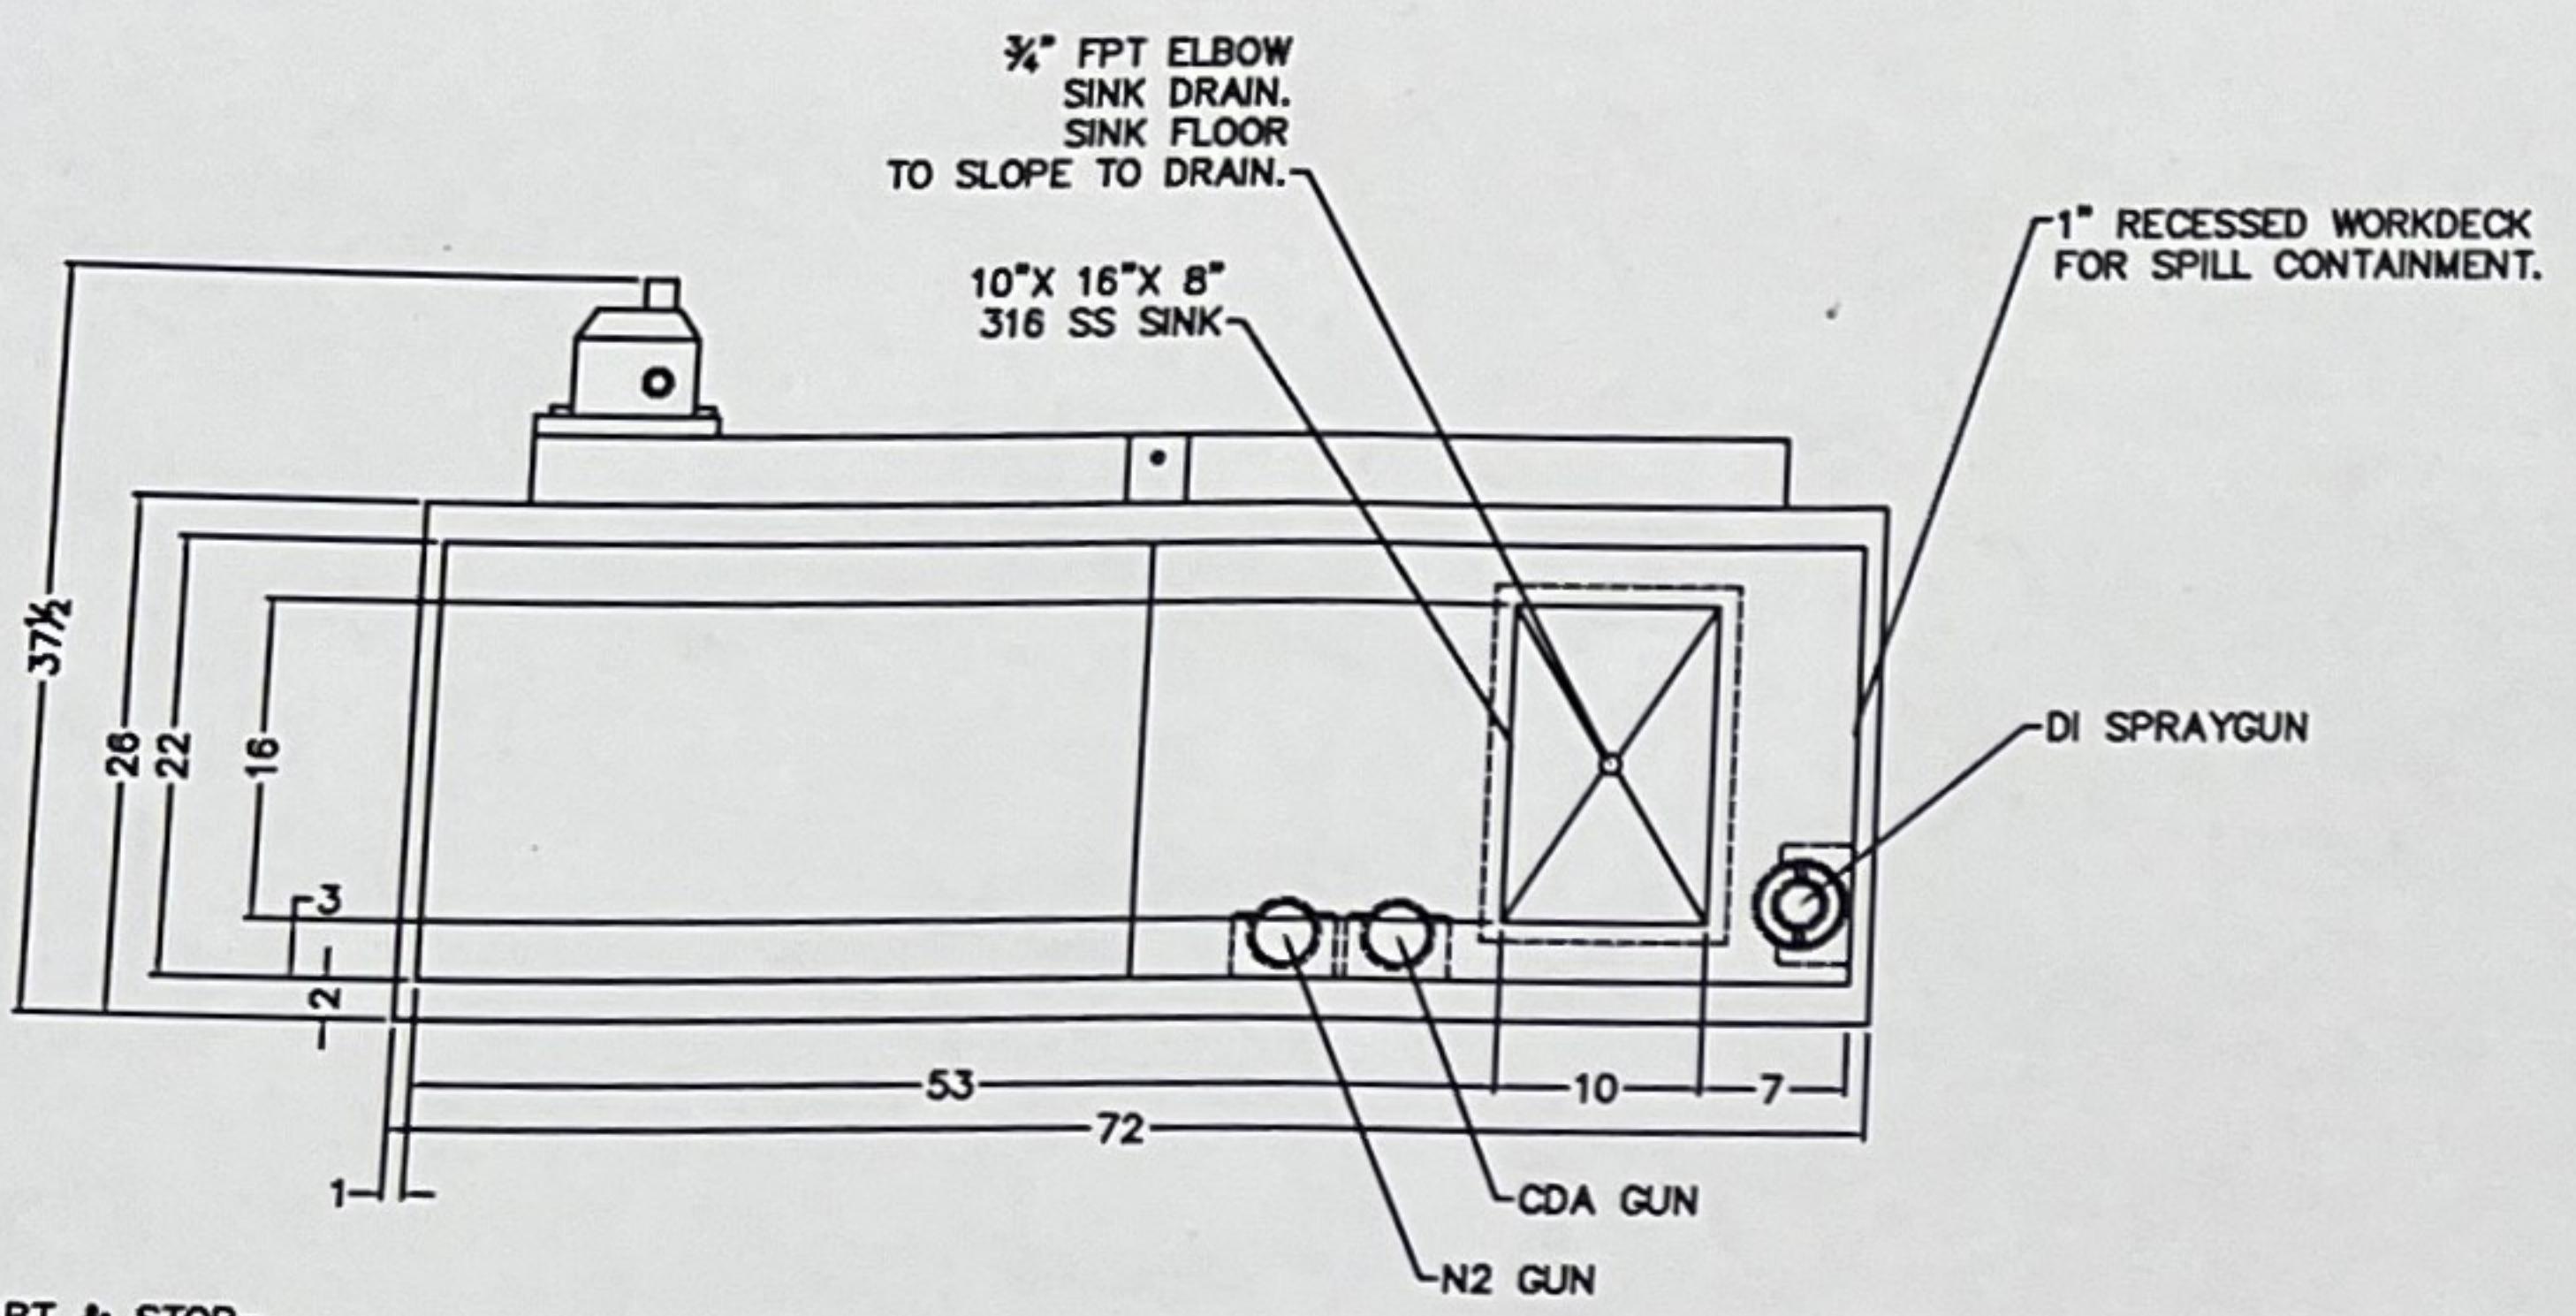



WORKDECK: PLAN VIEW

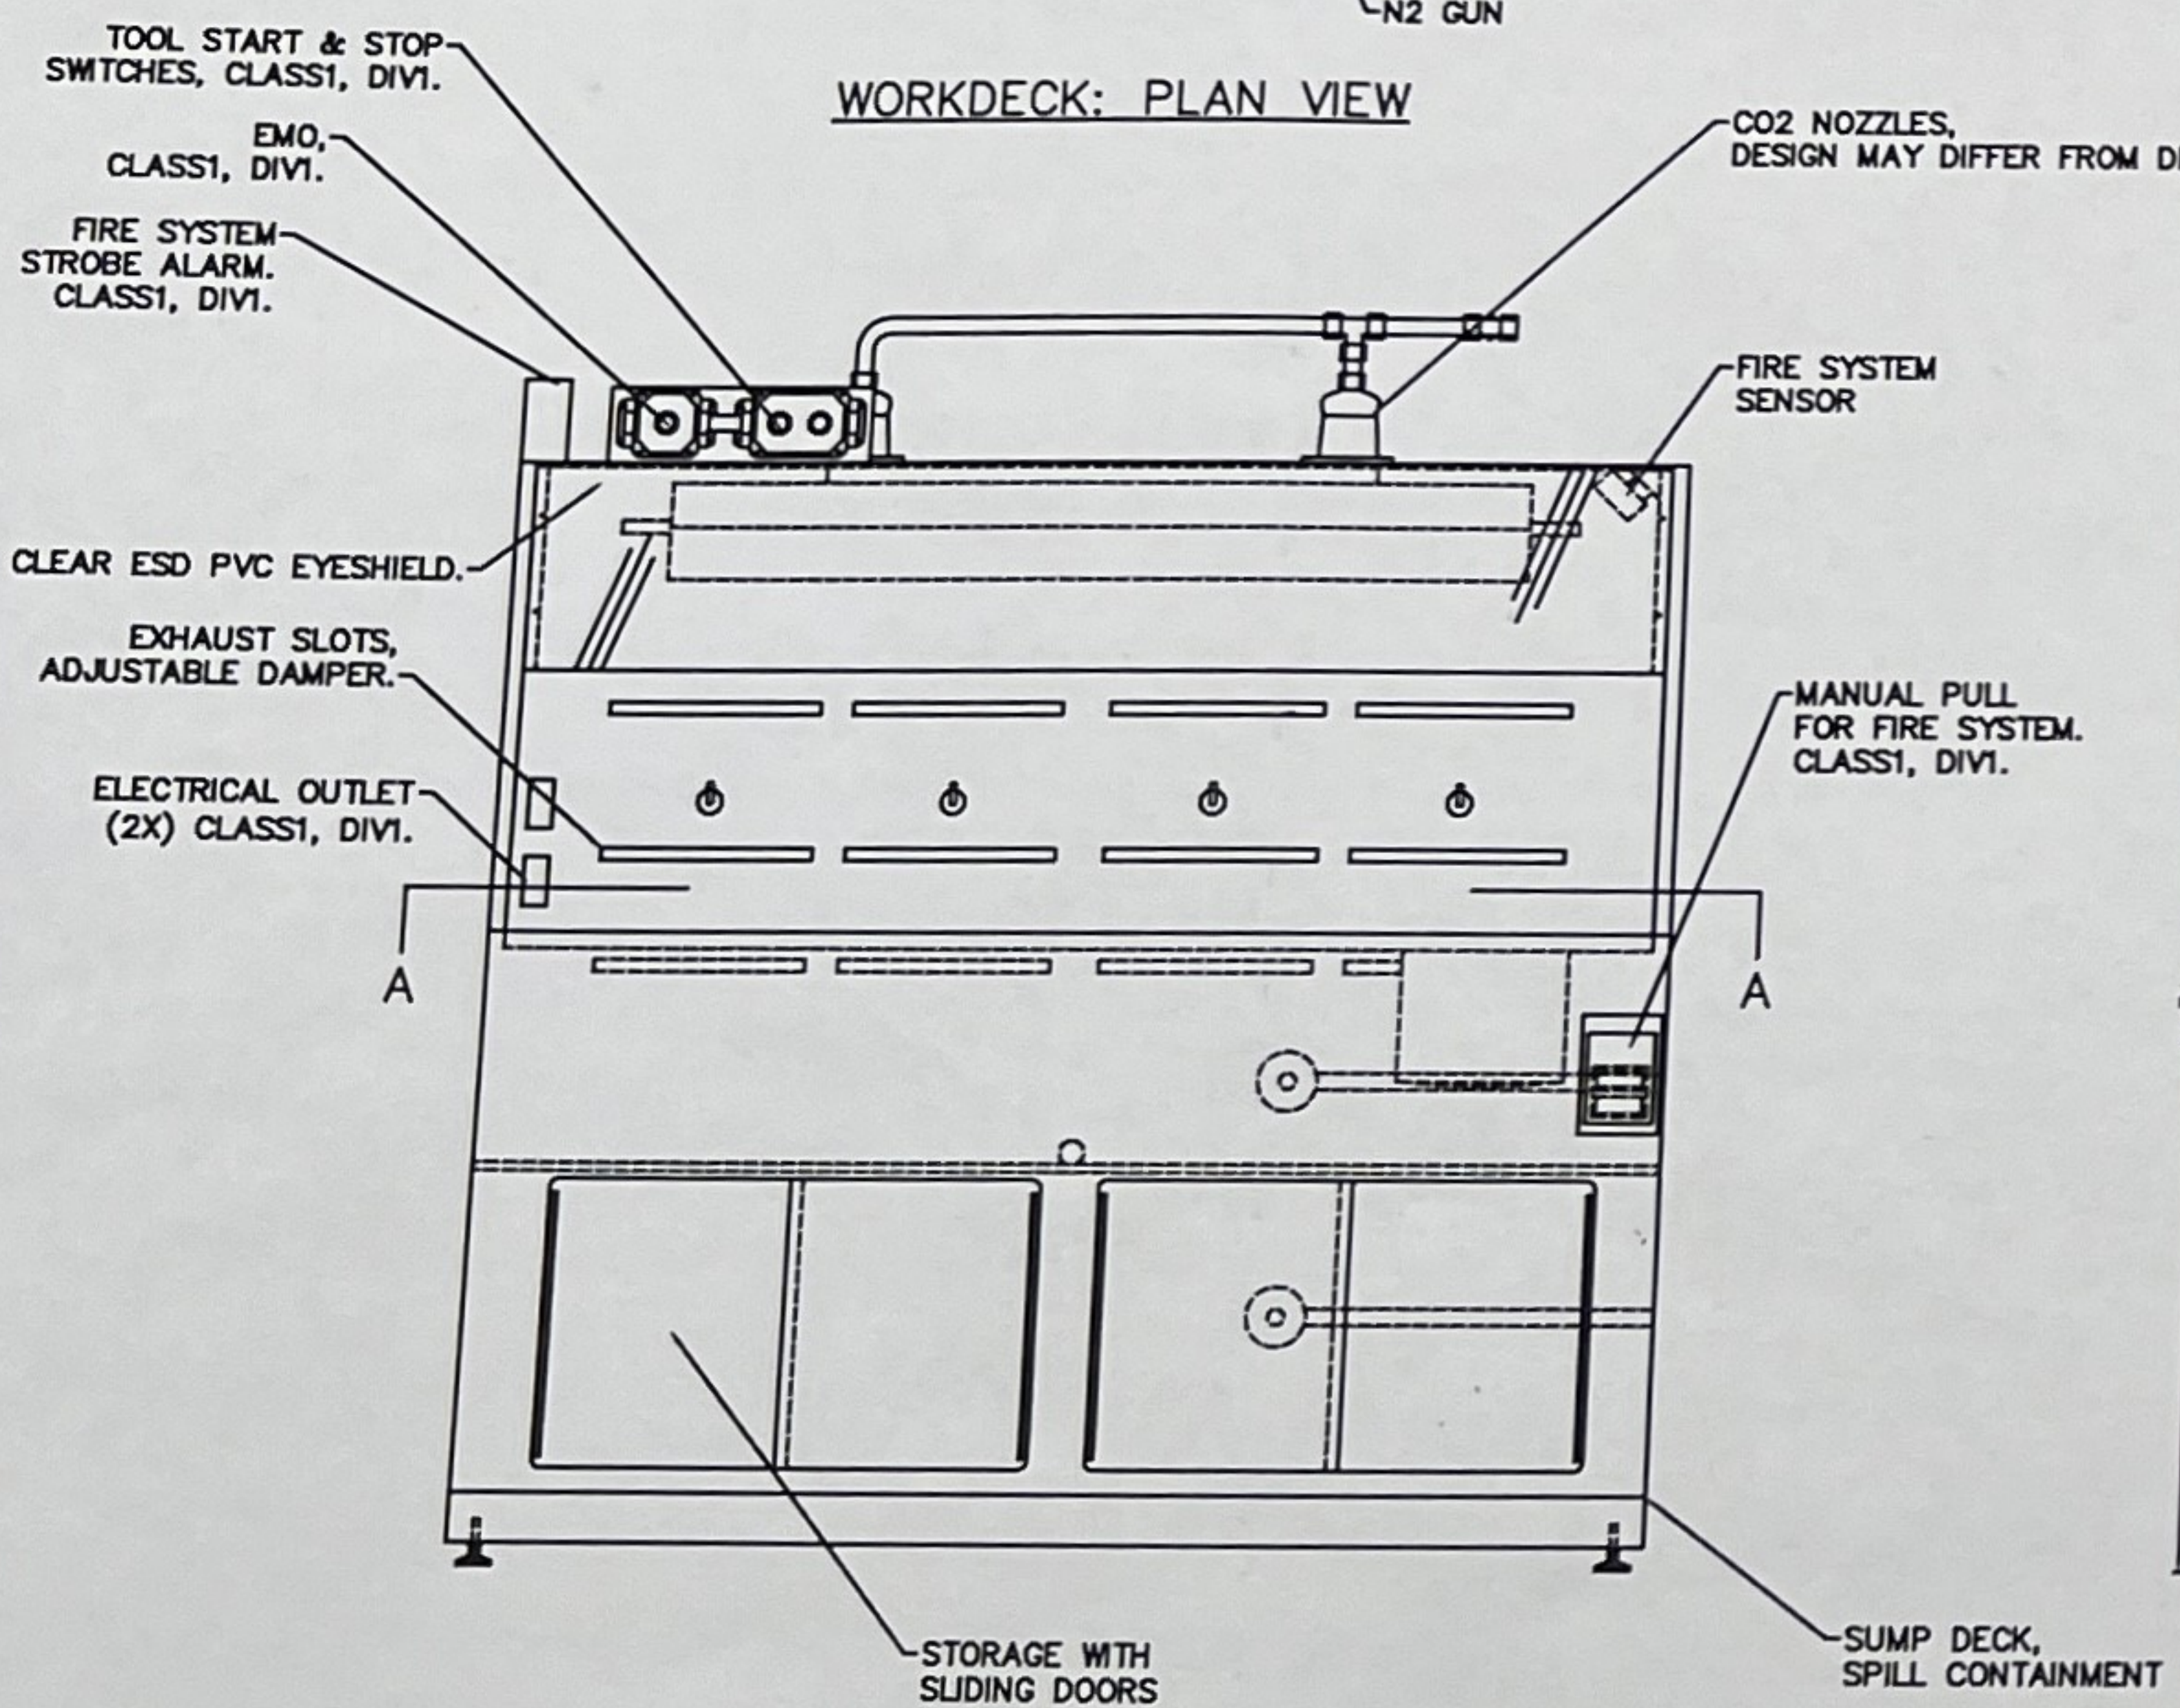

FRONT ELEVATION

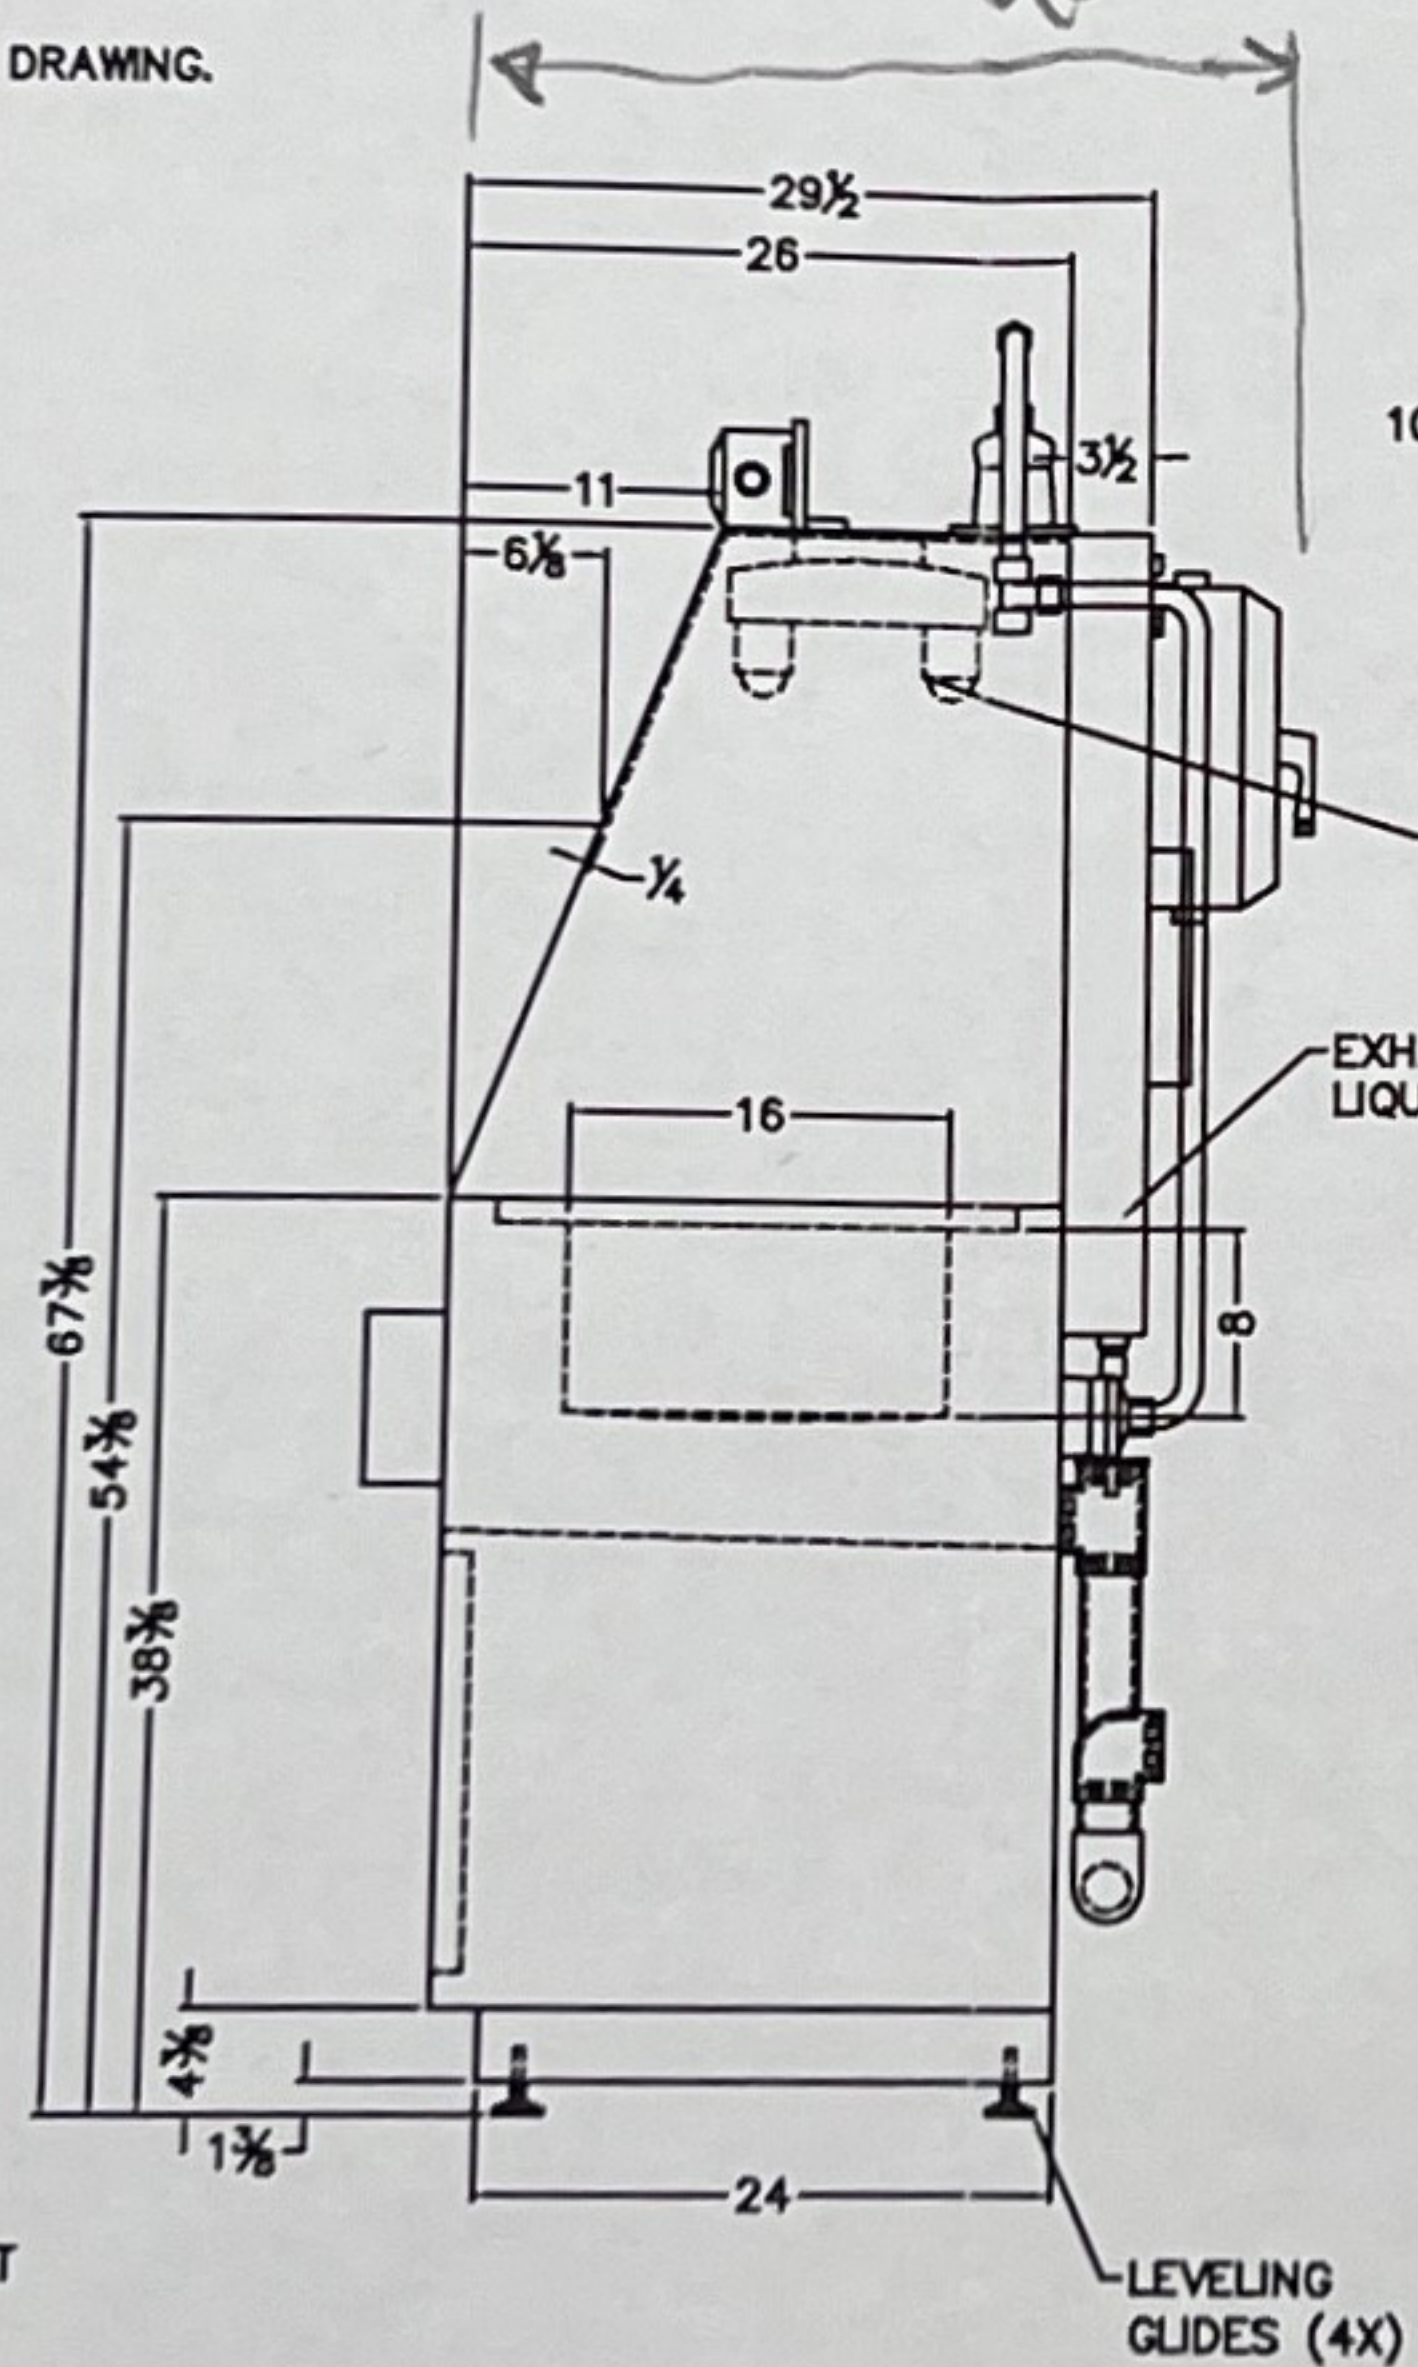

RIGHT END VIEW

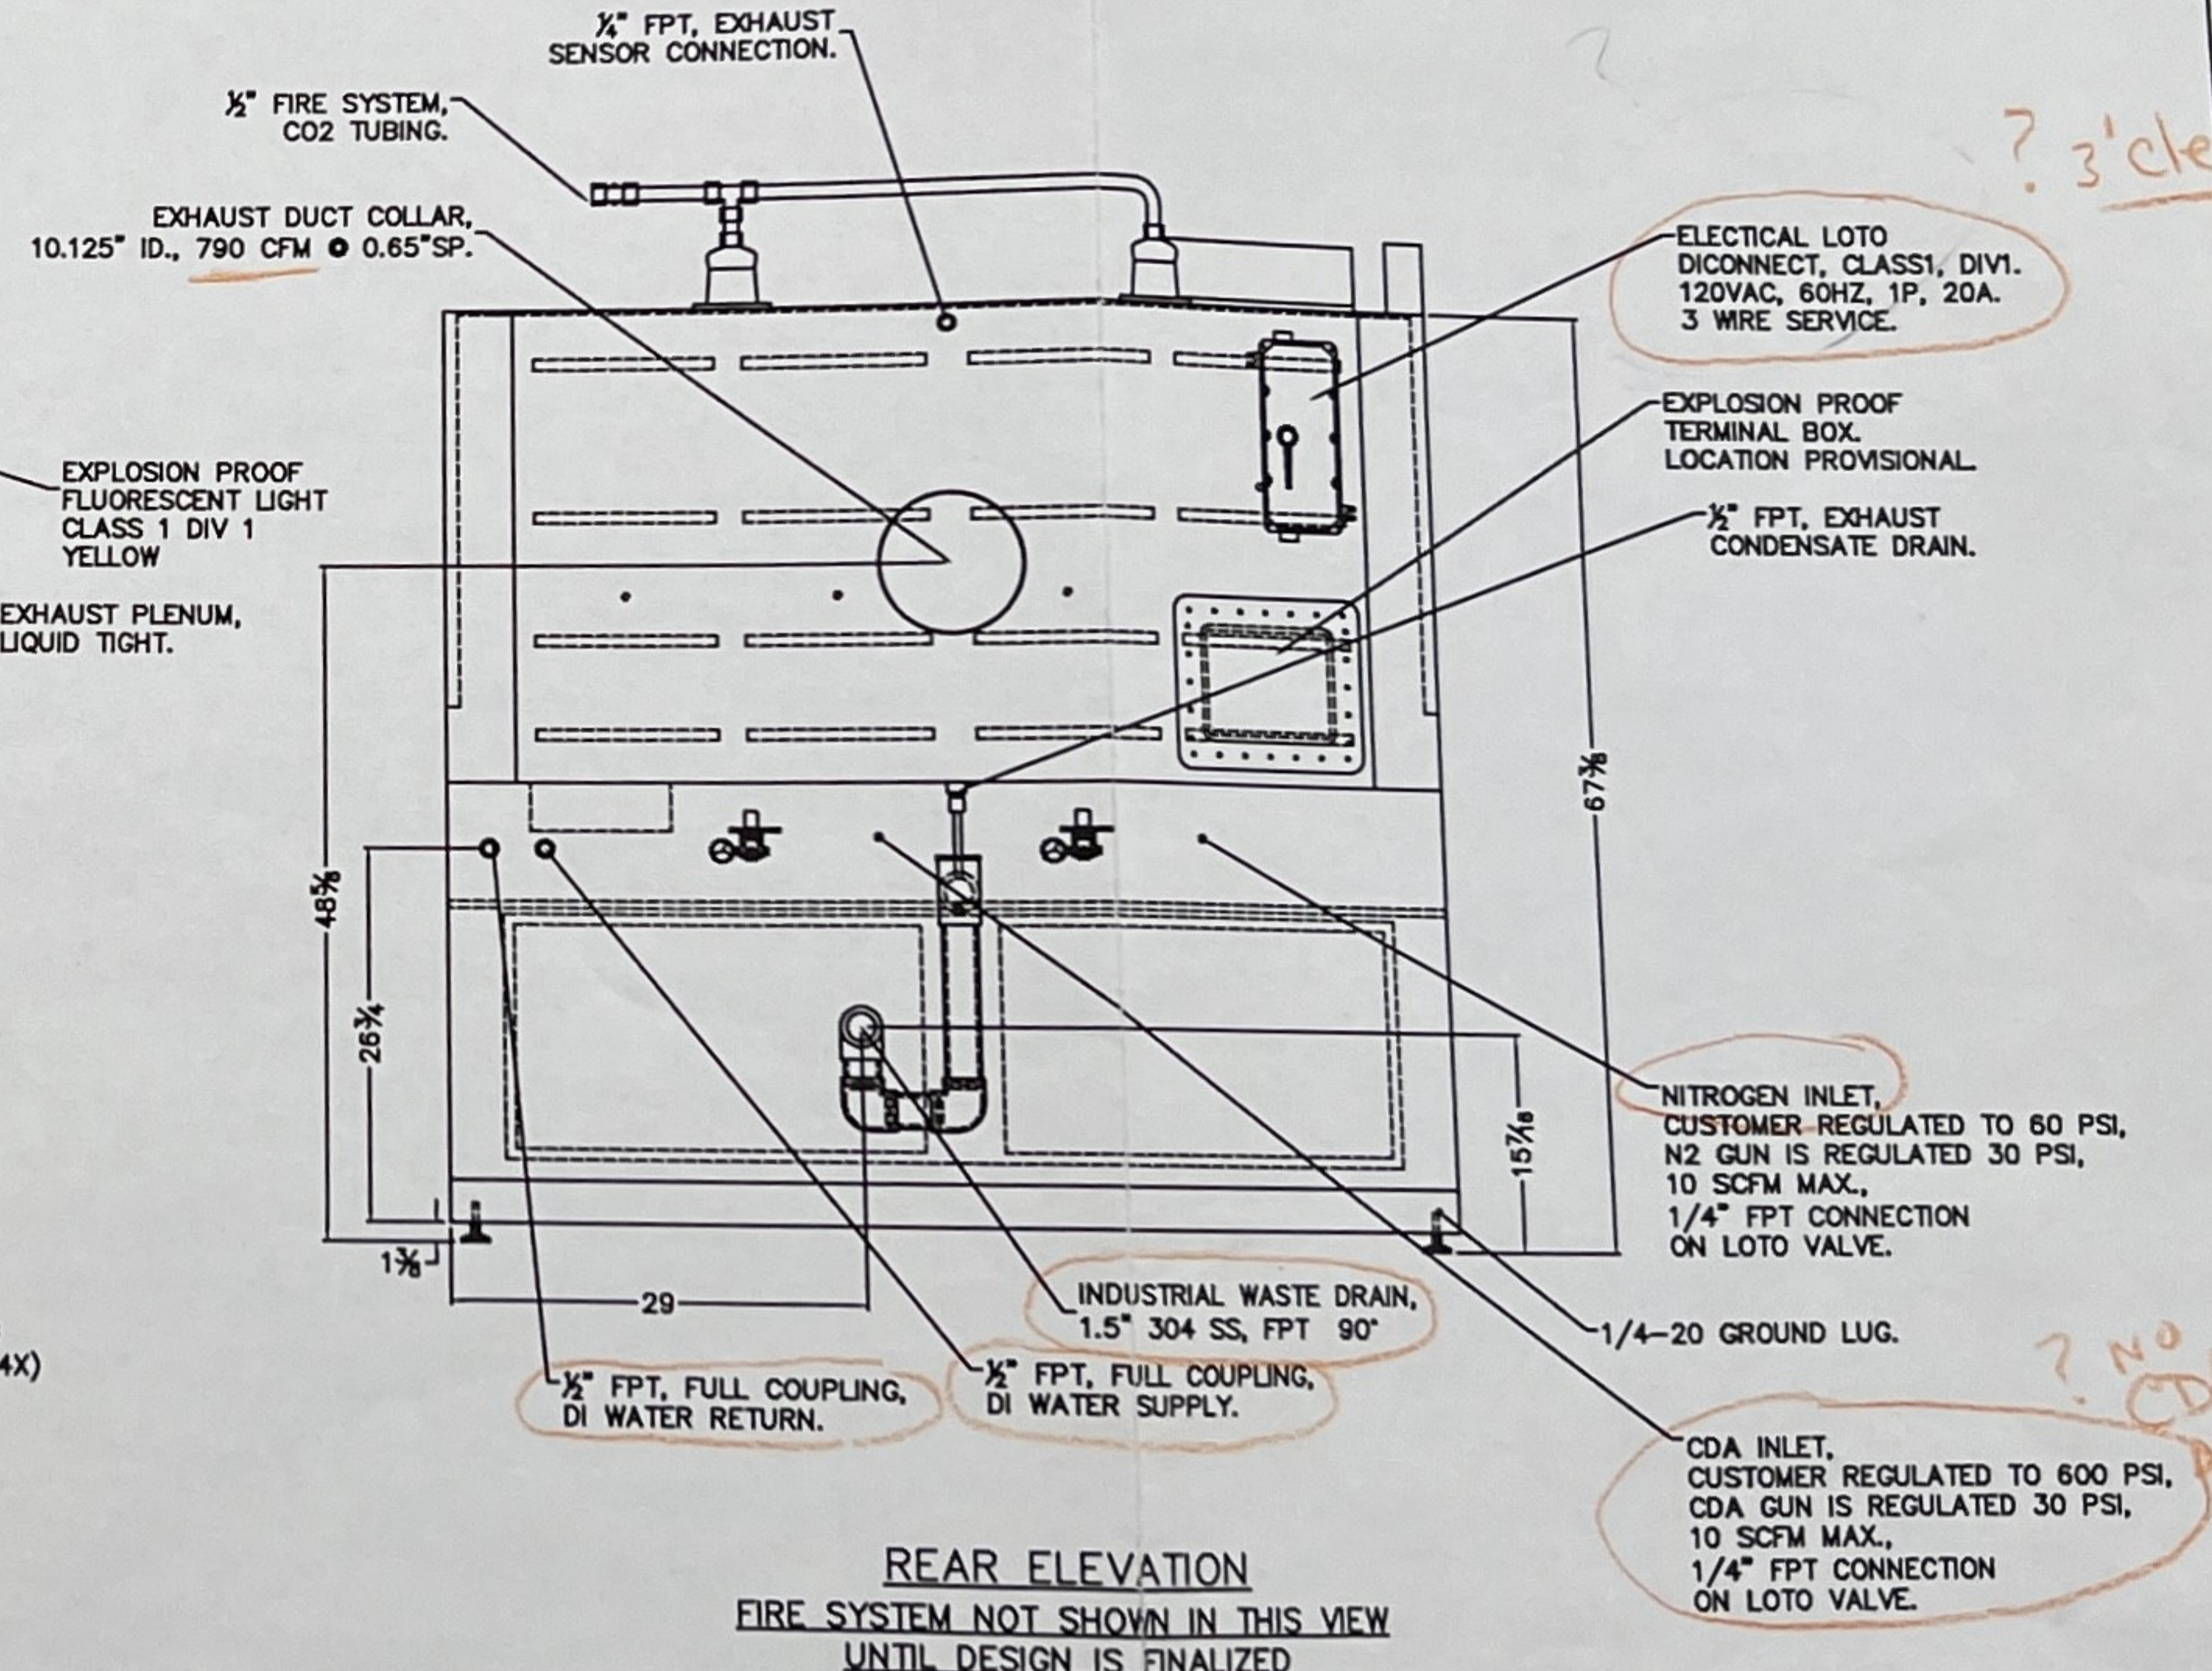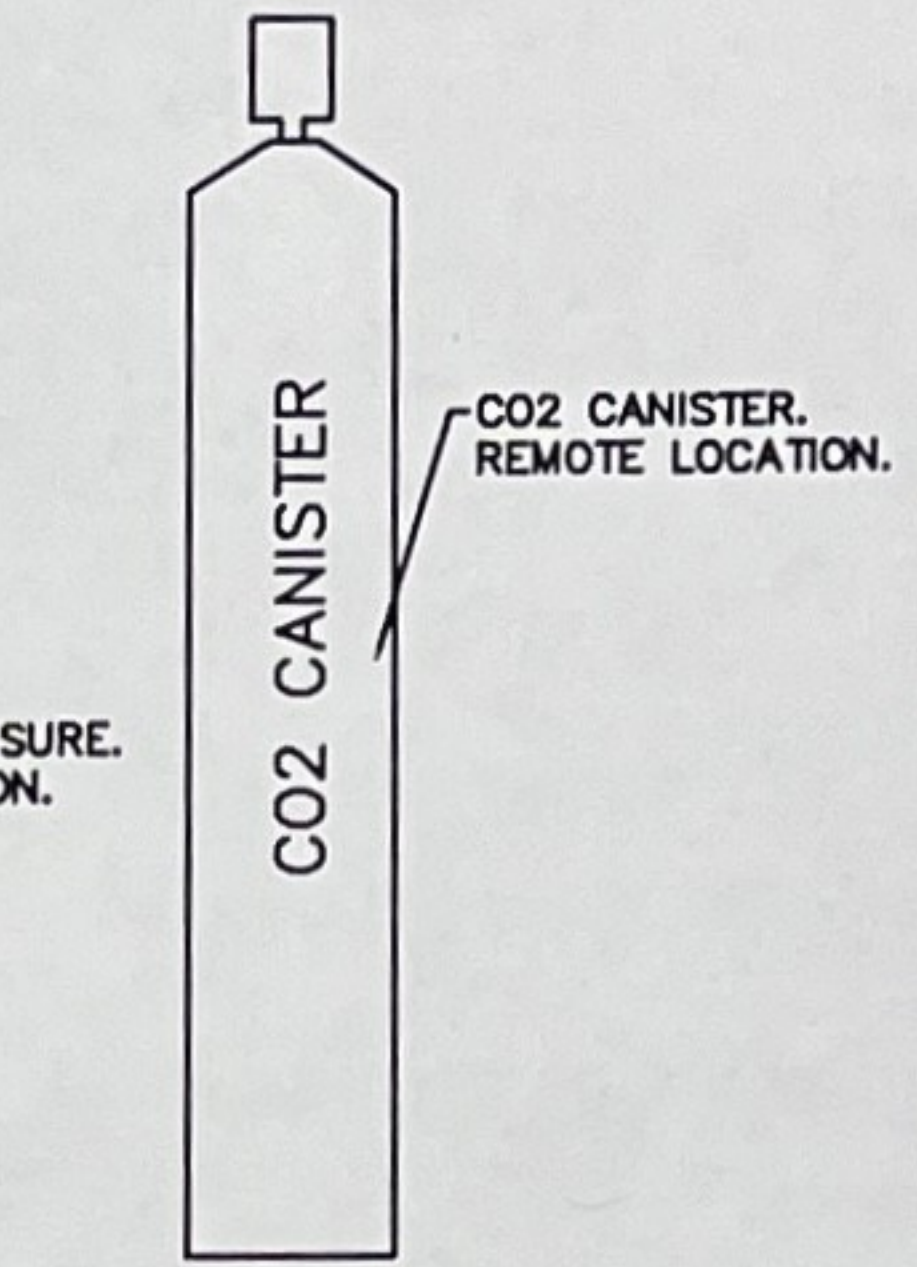

REAR ELEVATION
FIRE SYSTEM NOT SHOWN IN THIS VIEW
UNTIL DESIGN IS FINALIZED

CONTROLLED DOCUMENT

Initial JB Date 01/19/07

Copies of this document may not represent current information.

LEATHERWOOD PLASTICS

Design, Plastic Fabrication & Process Equipment
for the Printed Circuit Board, Microelectronics and Plating Industries
1426 Crescent Ave. * Lewisville, Texas 75057

SCALE: NONE	APPROVED BY: —	REV. B	DRAWN BY: B.Sch
DATE: 03/15/06		DATE: 01/19/07	SHEET: 1

TITLE: **SOLVENT FUME HOOD w REAR EXHAUST**

CUSTOMER: — DRAWING NUMBER: —